



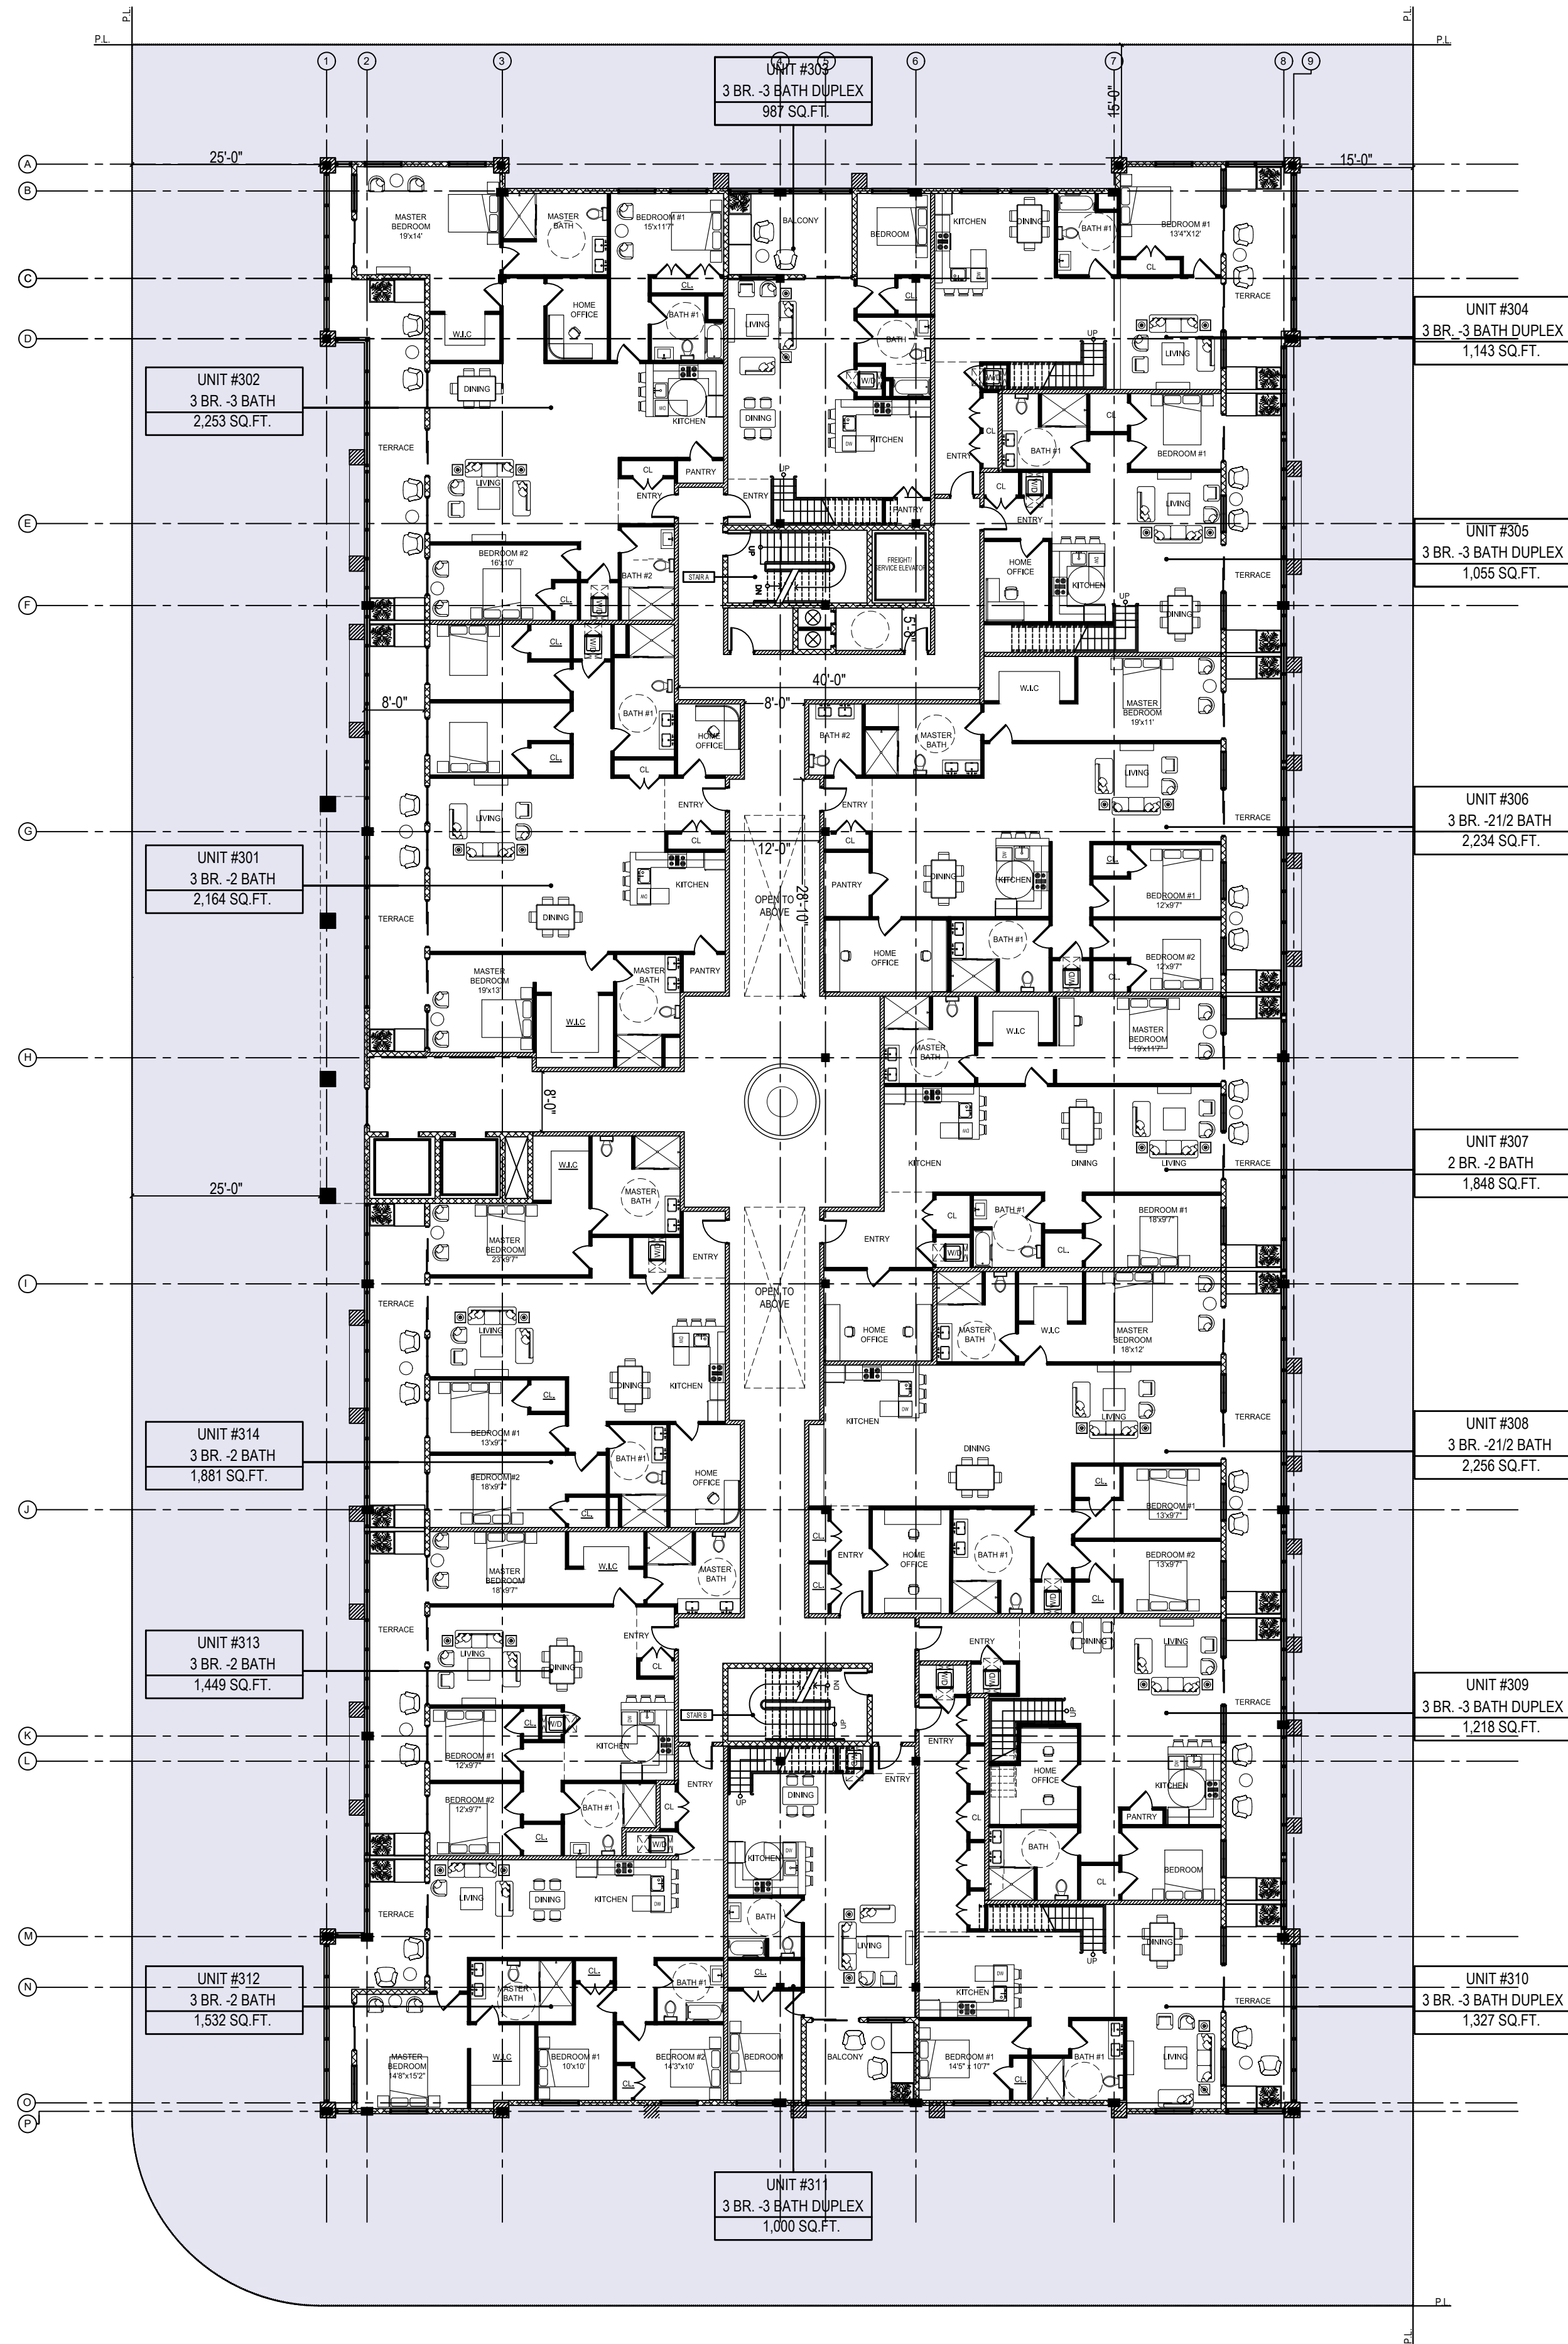

01 THIRD FLOOR - RESIDENTIAL
1/16"=1'-0"

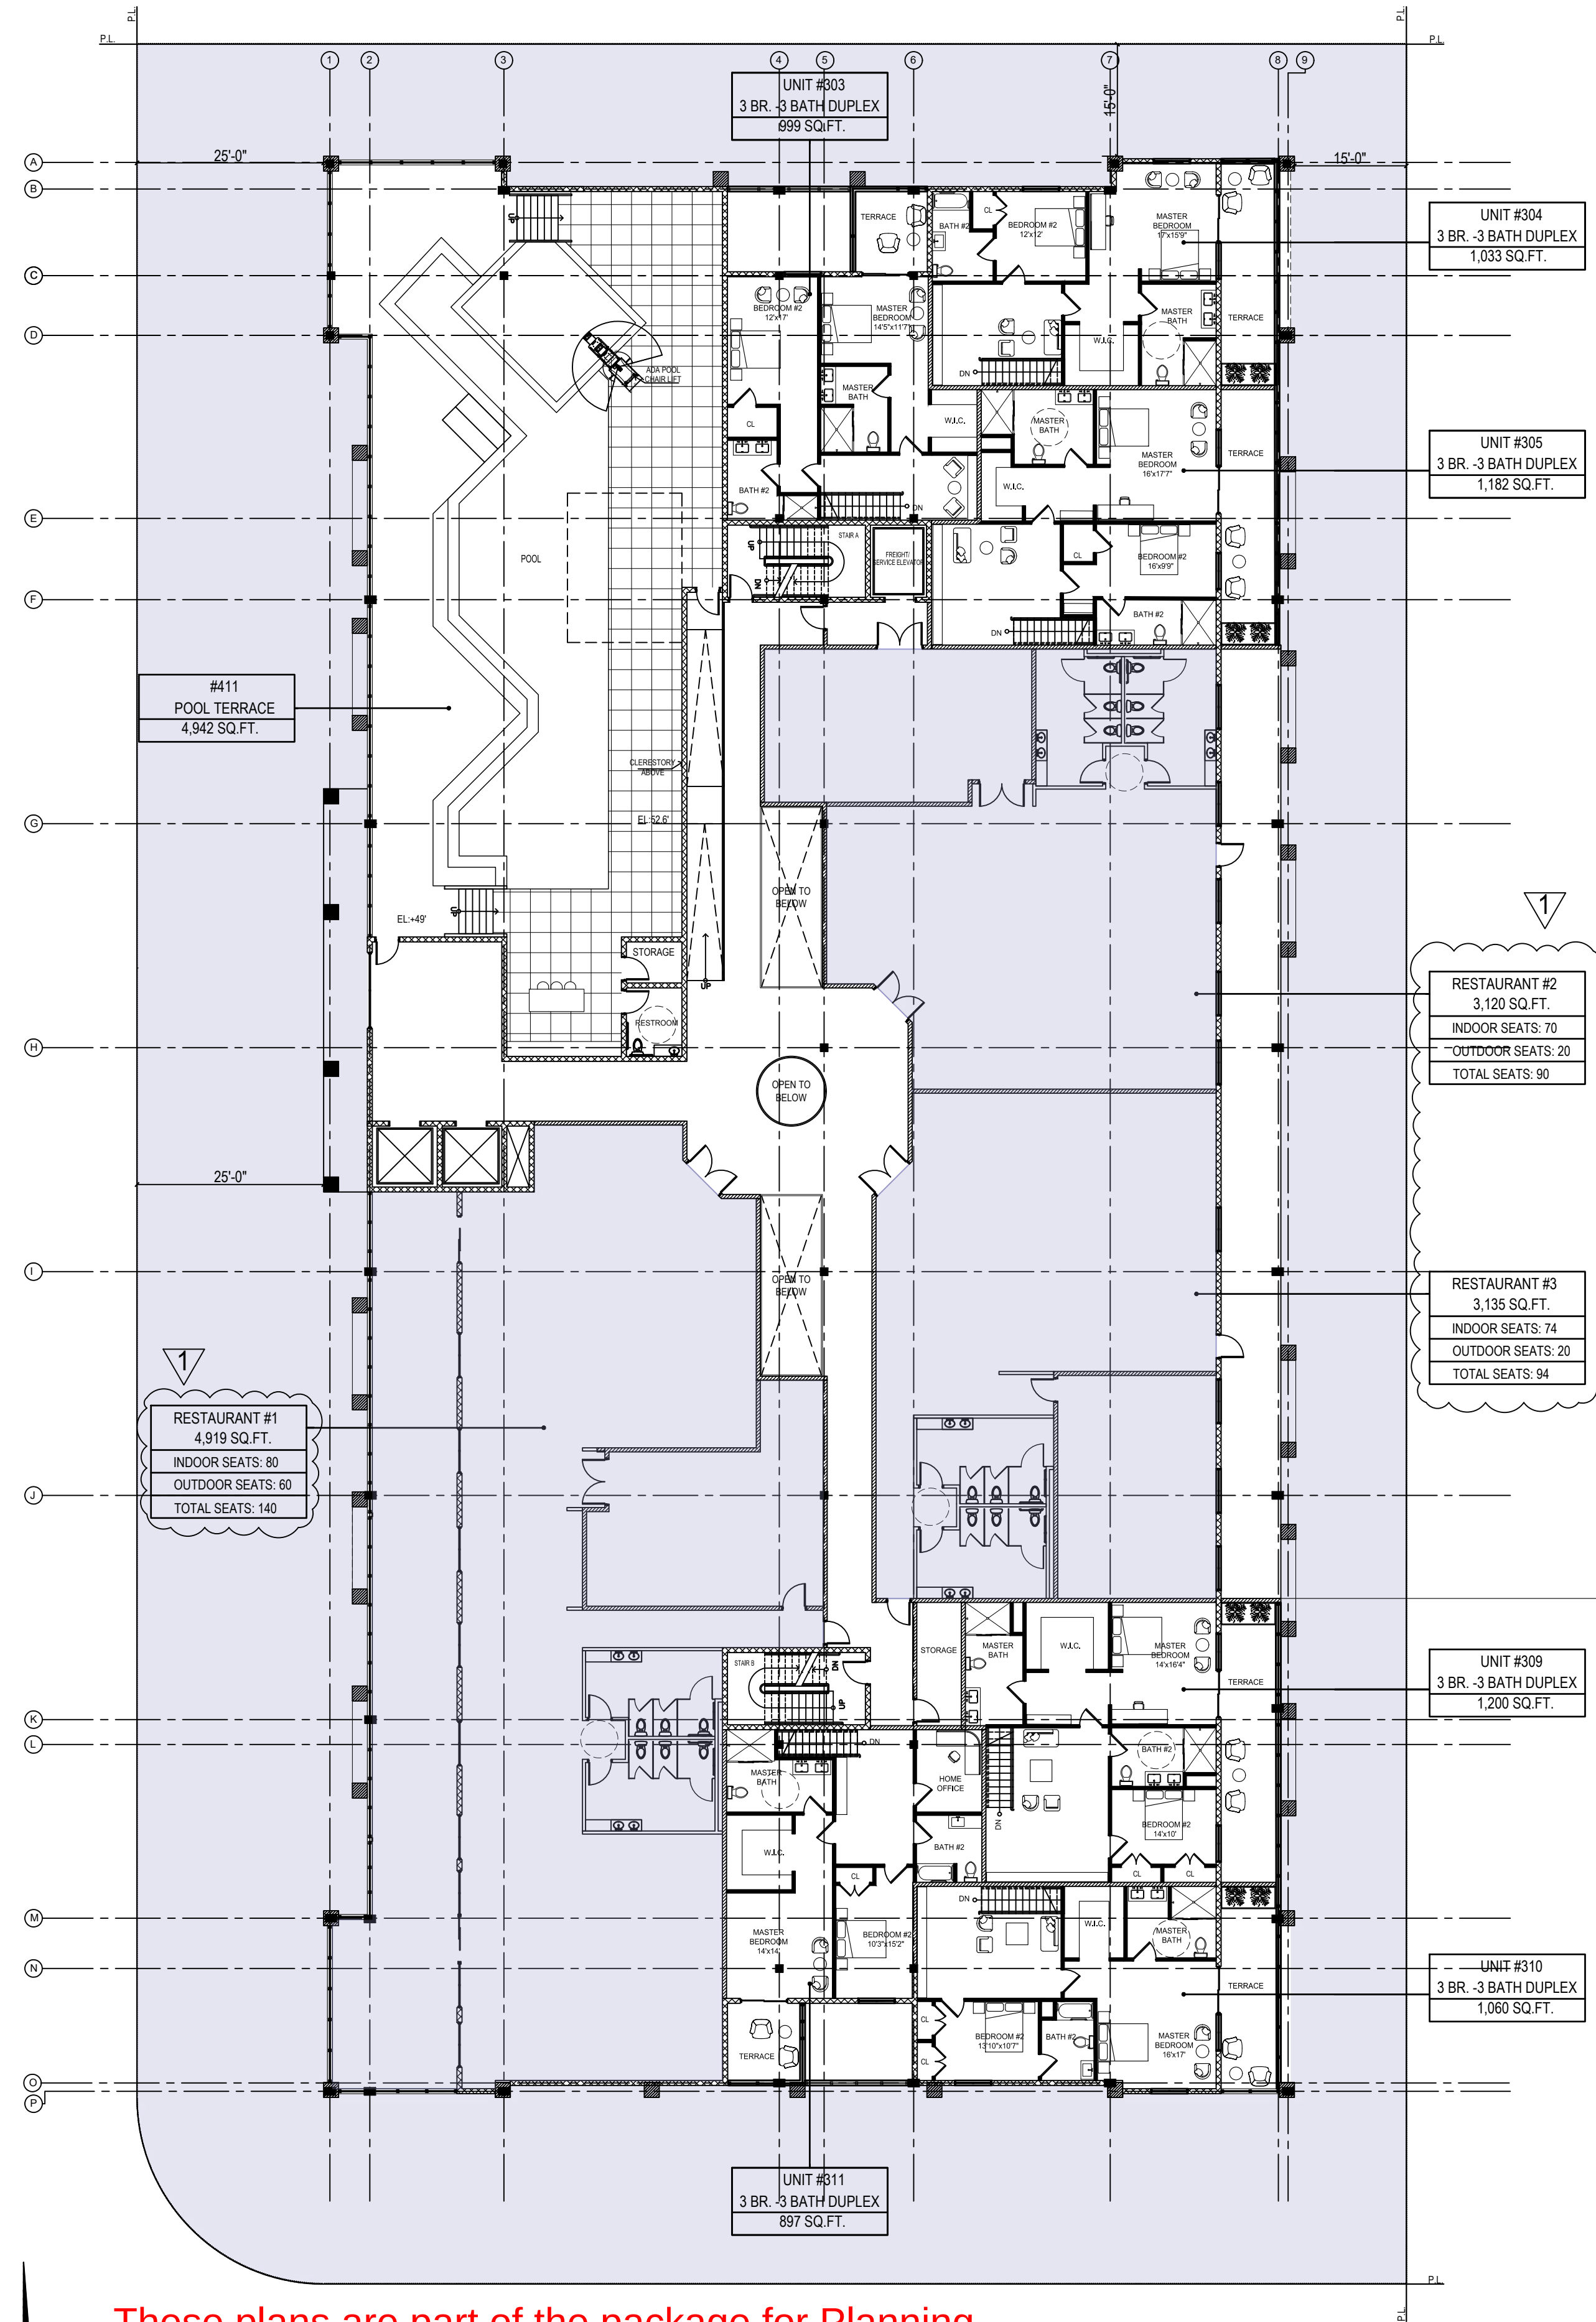

01 FOURTH FLOOR - RESIDENTIAL
1/16"=1'-0"

These plans are part of the package for Planning Board

THESE PLANS ARE AN INSTRUMENT OF SERVICE AND ARE THE PROPERTY OF THE ARCHITECT. THE PLANS MAY NOT BE USED FOR ANY OTHER PROJECT, NOR BY ANOTHER ARCHITECT FOR THE CONTINUATION OF THE PROJECT, NOR SOLD WITHOUT THE ARCHITECT'S WRITTEN AUTHORIZATION.

No.	REVISION	Date
1	PLANNING BOARD REVIEW COMMENTS	02/07/2023

ARCHITECT OF RECORD
ALAN J. HORWITZ, AIA, LEED AP BD C
FL LICENSE AR101841
6701 JF KENNEDY BLVD
NORTH BERGEN, NJ 07047
908-331-1948

Digitally signed by Alan J. Horwitz
Date: 2023.02.07 16:06:12 -05'00'

No.	Issue	Date
1	PLANNING BOARD REVIEW	9/13/22
2	PLANNING BOARD SUBMISSION - UPDATED	12/9/22

PROJECT
E -Residences Marco Island
717 South Collier Blvd.
Marco Island, FL

DRAWING TITLE
3RD & 4TH RESIDENTIAL FLOOR PLANS

PROJECT NO. **22003**
SHEET NO. **A-102**