


Reviewed for code compliance  
M Holden  
07/07/2026 12:07:53 PM

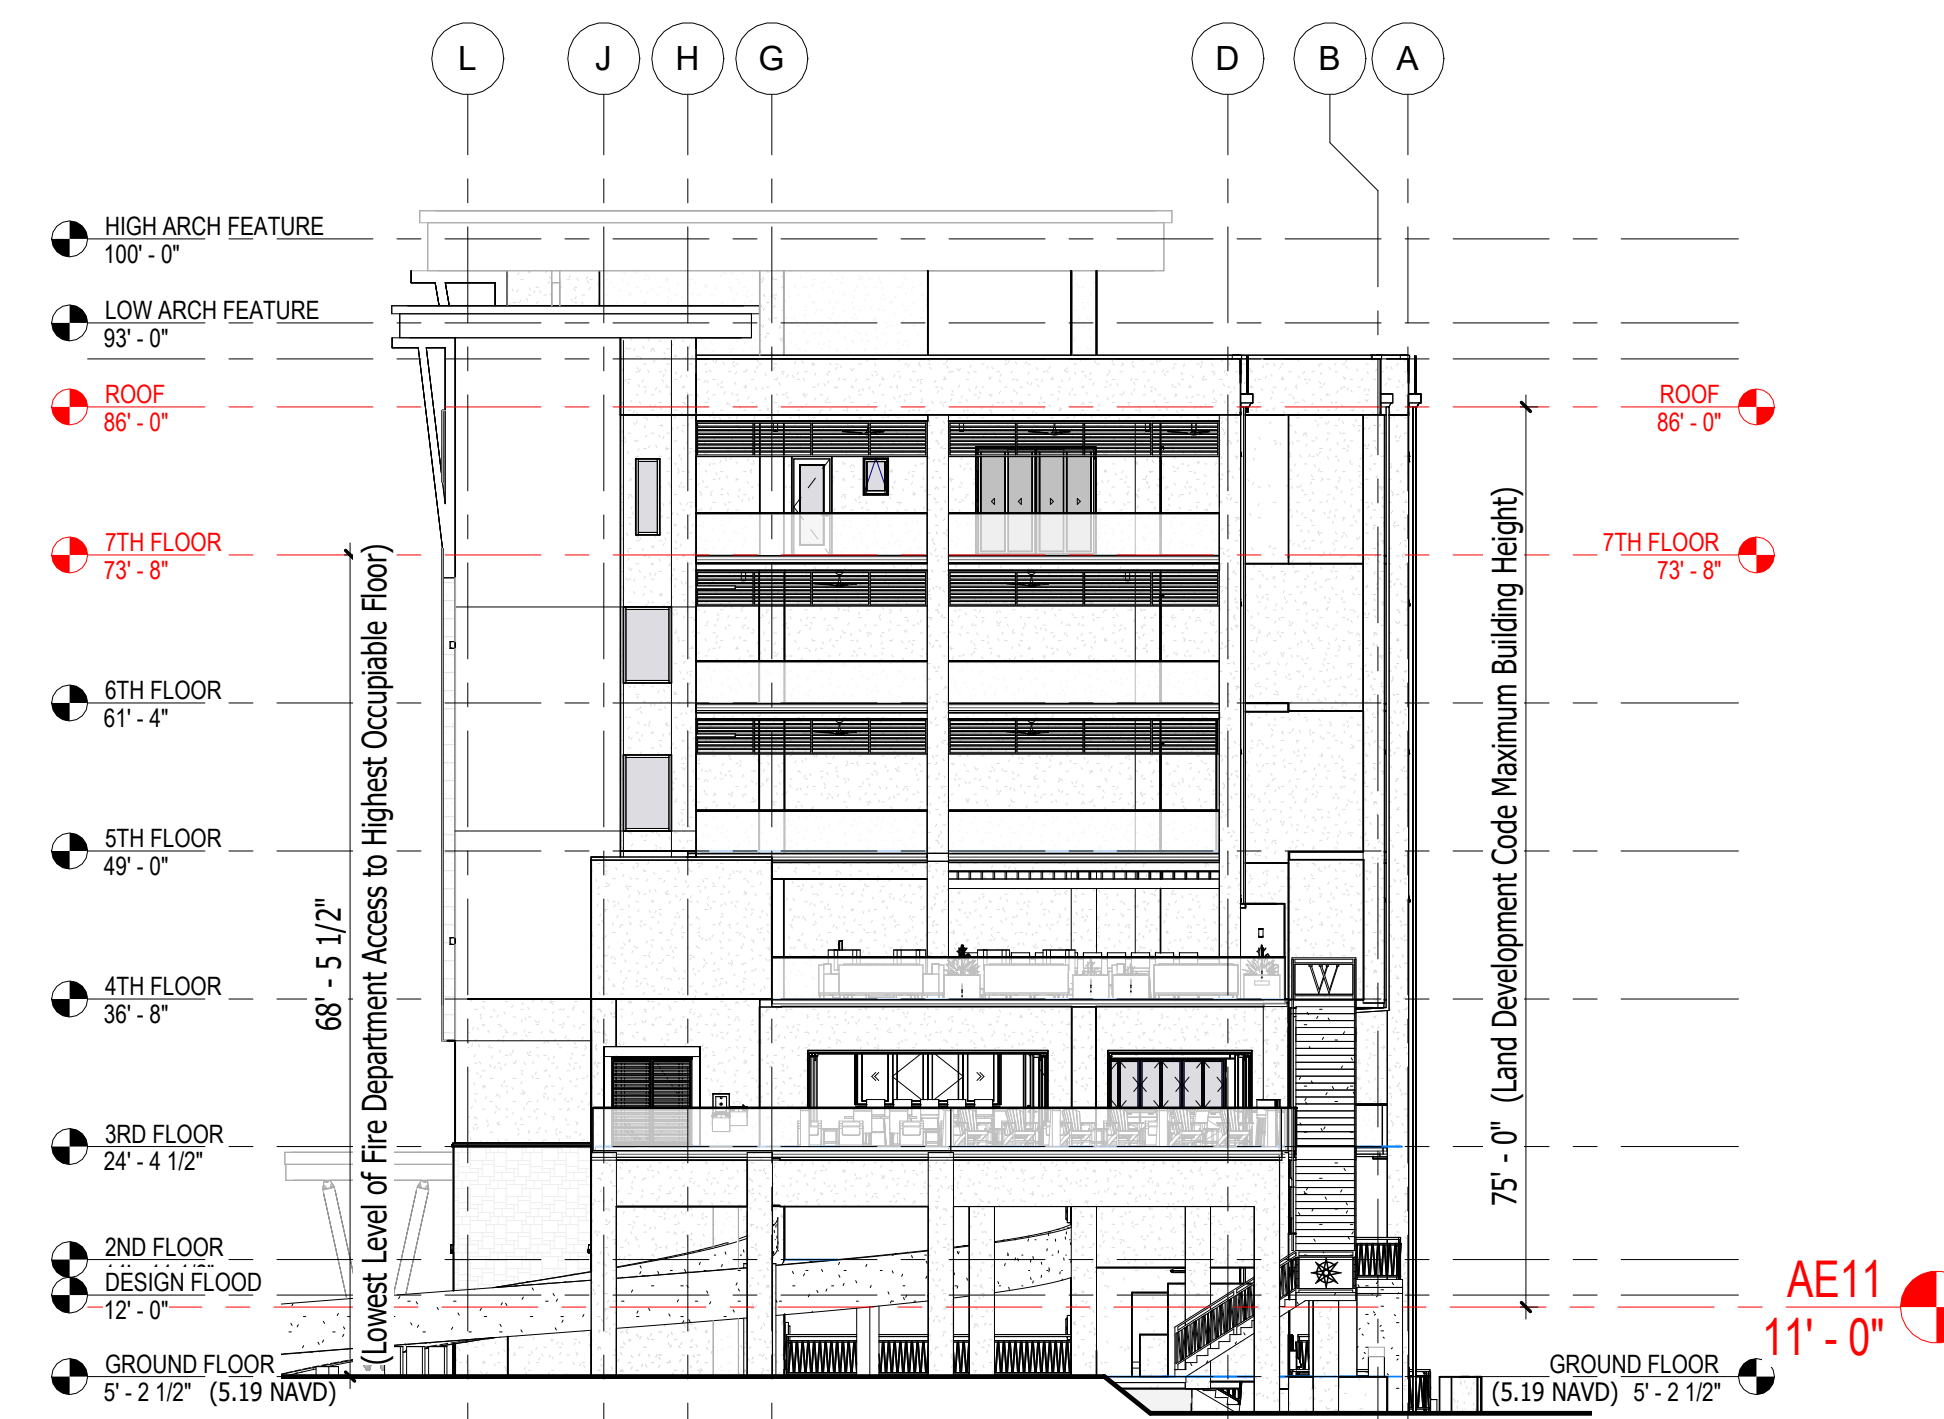

EAST ELEVATION

1/16" = 1'-0"

4



WEST ELEVATION

1/16" = 1'-0"

3



NORTH ELEVATION

1/16" = 1'-0"

2




SOUTH ELEVATION

1/16" = 1'-0"

1

PLAN REVIEW

| NO. | DATE | ISSUE / REVISION | DESCRIPTION |
|-----|------|------------------|-------------|
|     |      |                  |             |

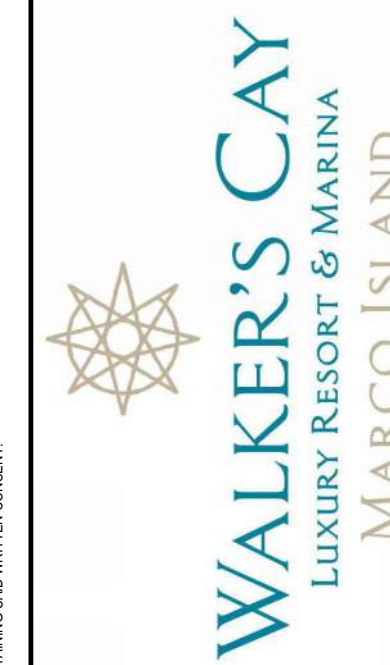

NEW LUXURY HOTEL at  
**WALKER'S CAY**  
3200 SAN MARCO ROAD  
MARCO ISLAND, FLORIDA 34145

**PDS ARCHITECTURE INC.**  
12800 UNIVERSITY DR. SUITE 402  
FT MYERS, FL 33907  
FL LICENSE # 97143  
PH: 239.437.8090  
FX: 855.635.2733  
INFO@PDSinonline.com



DATE: 01 JUNE 2026  
TITLE: ELEVATIONS

SHEET NO.  
**SK-02**