


These plans are part of
the package for
Planning Board

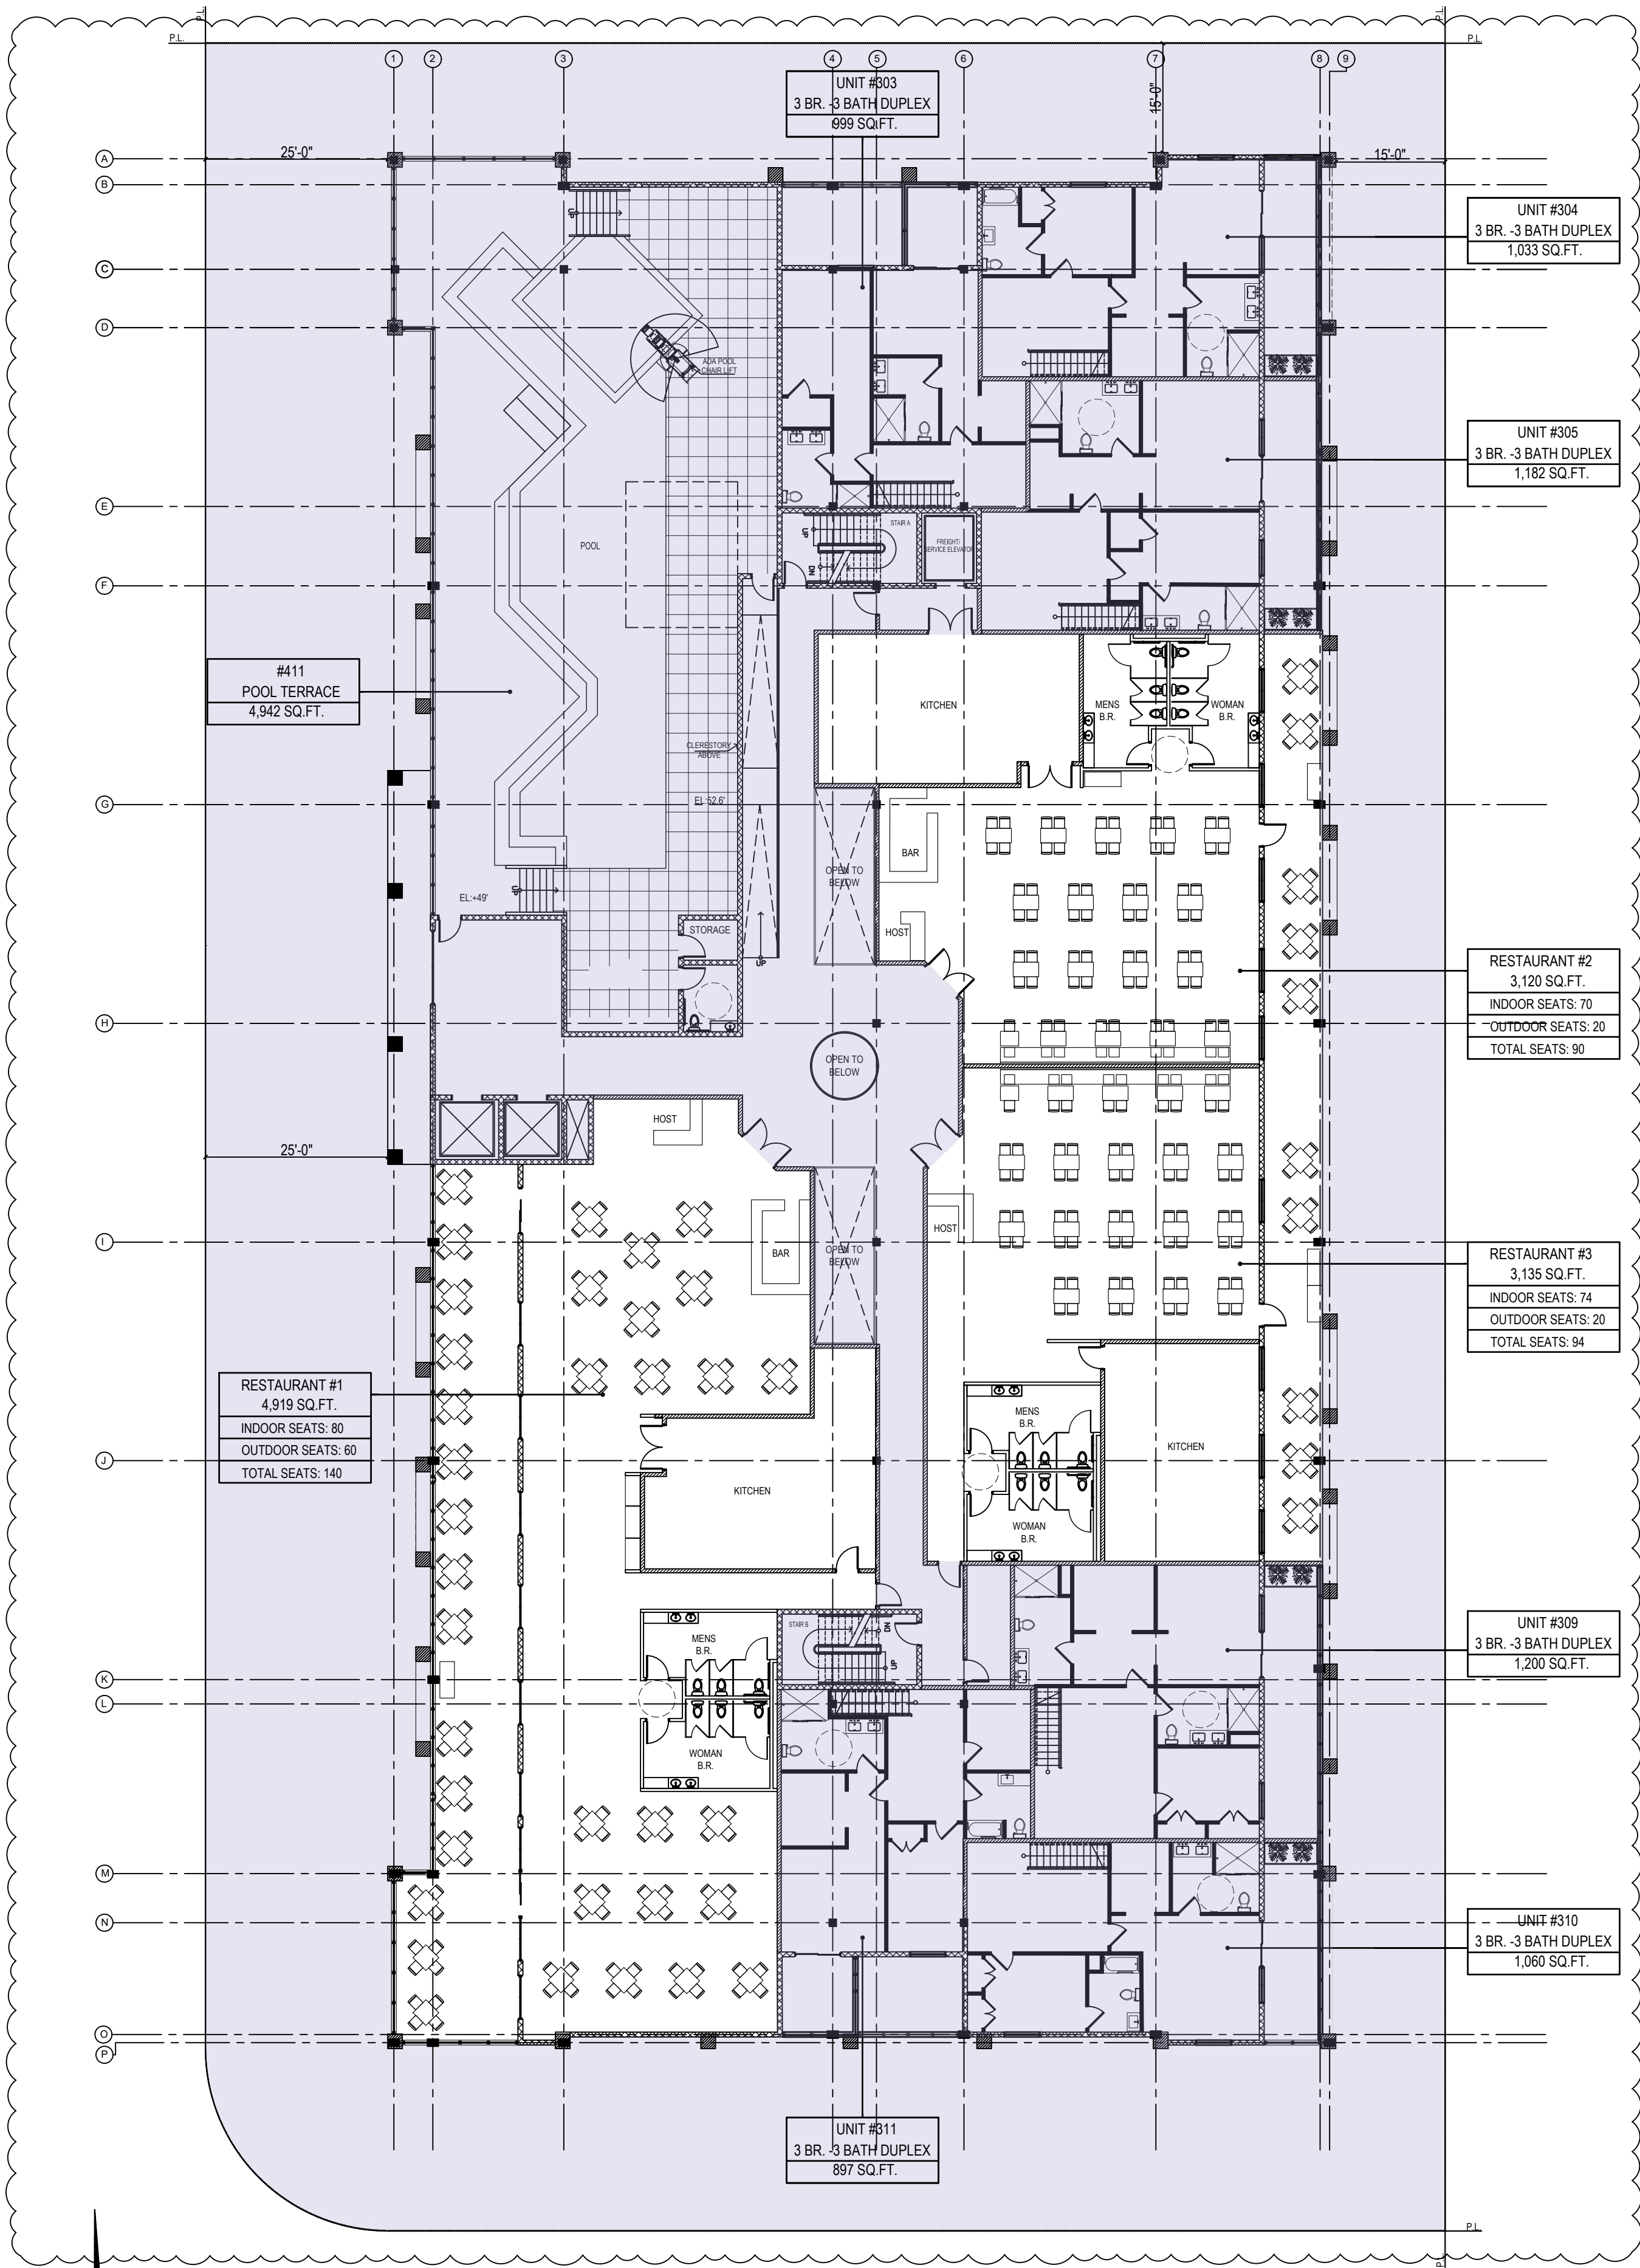

01 FOURTH FLOOR - CONCEPT RESTAURANT LAYOUT
1/16"=1'-0"




BASELINE
Architecture Interior Design Planning

Montclair and North Bergen, New Jersey
www.baselinearch.com

THESE PLANS ARE AN INSTRUMENT OF SERVICE AND ARE THE PROPERTY OF THE ARCHITECT. THE PLANS MAY NOT BE USED FOR ANY OTHER PROJECT, NOR BY ANOTHER ARCHITECT FOR THE CONTINUATION OF THE PROJECT, NOR SOLD WITHOUT THE ARCHITECT'S WRITTEN AUTHORIZATION.

No.	REVISION	Date
1	PLANNING BOARD REVIEW COMMENTS	02/07/2023

ARCHITECT OF RECORD
ALAN J. HORWITZ, AIA, LEED AP BD C
FL LICENSE AR101841
6701 JF KENNEDY BLVD
NORTH BERGEN, NJ 07047
908-331-1948

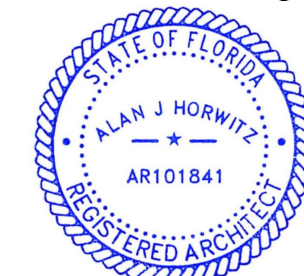

Digitally signed
by Alan
Horwitz
Date:
2023.02.07
16:08:12 -05'00'

Printed copies of this document are not considered signed and sealed, and the signature must be verified on any electronic copies.	Issue	Date
1	PLANNING BOARD REVIEW	9/13/22
2	PLANNING BOARD SUBMISSION - UPDATED	12/9/22

PROJECT
E -Residences Marco Island
717 South Collier Blvd.
Marco Island, FL

DRAWING TITLE
**4TH FLOOR CONCEPT
RESTAURANT LAYOUT**

PROJECT NO. **22003**
SHEET NO. **A-104**