


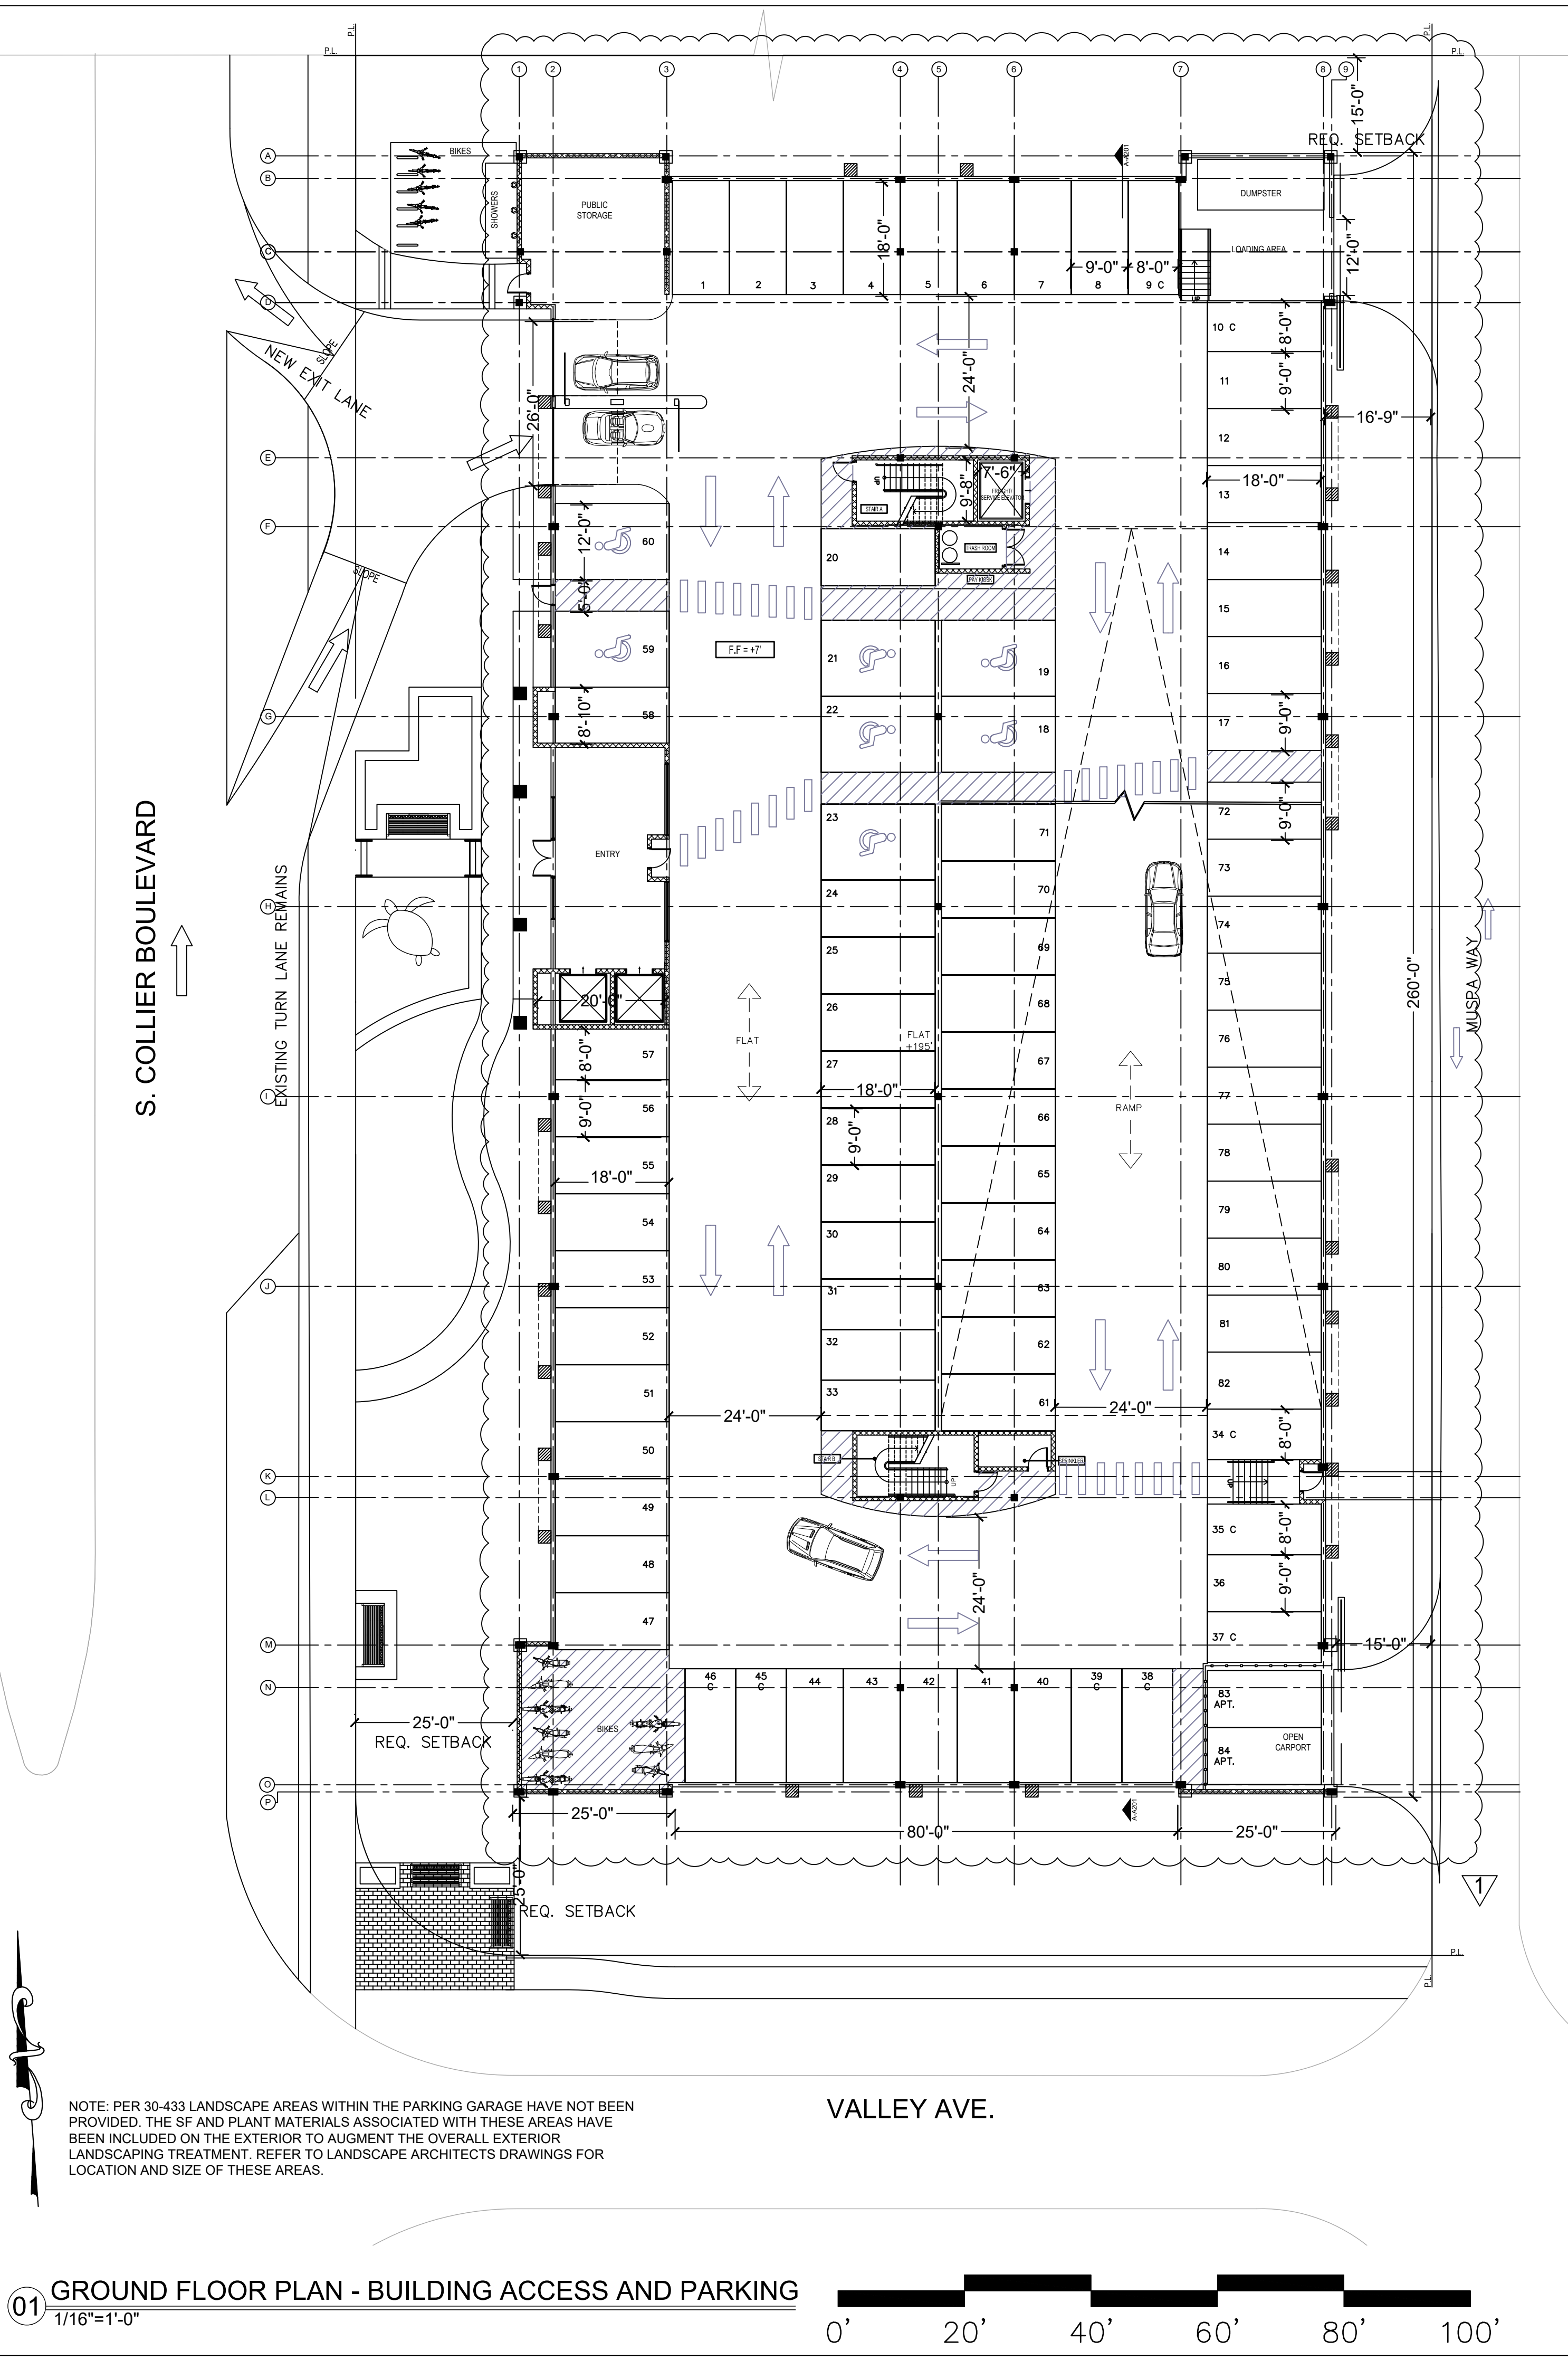

01 GROUND FLOOR PLAN - BUILDING ACCESS AND PARKING
1/16"=1'-0"



02 PARKING ENTRANCE - S. COLLIER BLVD
N.T.S.



03 RESIDENTIAL & RESTAURANT ENTRANCE - S. COLLIER BLVD
N.T.S.



04 S. COLLIER BLVD - VALLEY AVE - MAIN ENTRANCE & TURTLE PLAY AREA
N.T.S.

H. Tejada
SDP reviewed

THESE PLANS ARE AN INSTRUMENT OF SERVICE AND ARE THE PROPERTY OF THE ARCHITECT. THE PLANS MAY NOT BE USED FOR ANY OTHER PROJECT, NOR BY ANOTHER ARCHITECT FOR THE CONTINUATION OF THE PROJECT, NOR SOLD WITHOUT THE ARCHITECT'S WRITTEN AUTHORIZATION.

These plans
are part of the
package for
Planning Board

No.	REVISION	Date
1	PLANNING BOARD REVIEW COMMENTS	02/07/2023

ARCHITECT OF RECORD
ALAN J. HORWITZ, AIA, LEED AP BD C
FL LICENSE AR101841
6701 JF KENNEDY BLVD
NORTH BERGEN, NJ 07047
908-331-1948

Digitally signed
by Alan
Horwitz
Date:
2023.02.07
16:04:09 -05'00'

No.	REVISION	Date
1	PLANNING BOARD REVIEW	9/13/22
2	PLANNING BOARD SUBMISSION - UPDATED	12/9/22

PROJECT
E -Residences Marco Island
717 South Collier Blvd.
Marco Island, FL

DRAWING TITLE
GROUND FLOOR PLAN

PROJECT NO. **22003**
SHEET NO. **A-100**