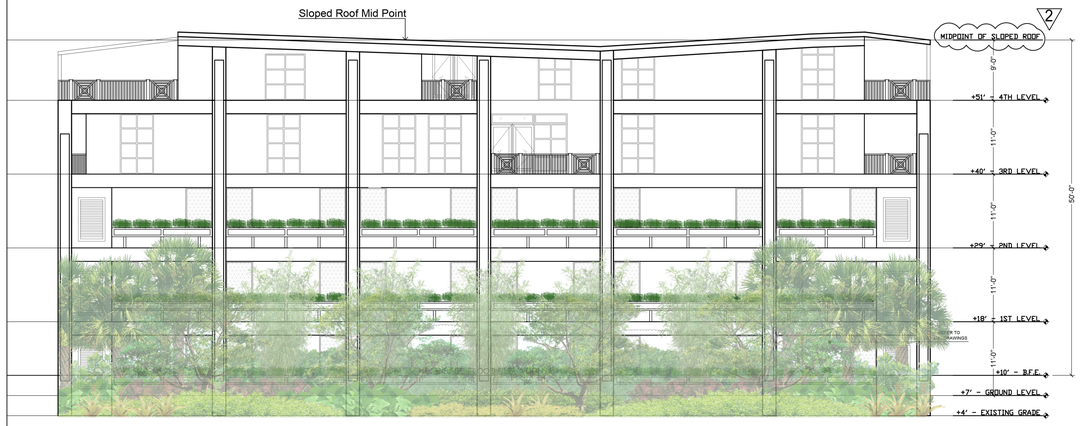

S SOUTH ELEVATION - VALLEY AVE.
3/32"=1'-0"

N NORTH ELEVATION
3/32"=1'-0"

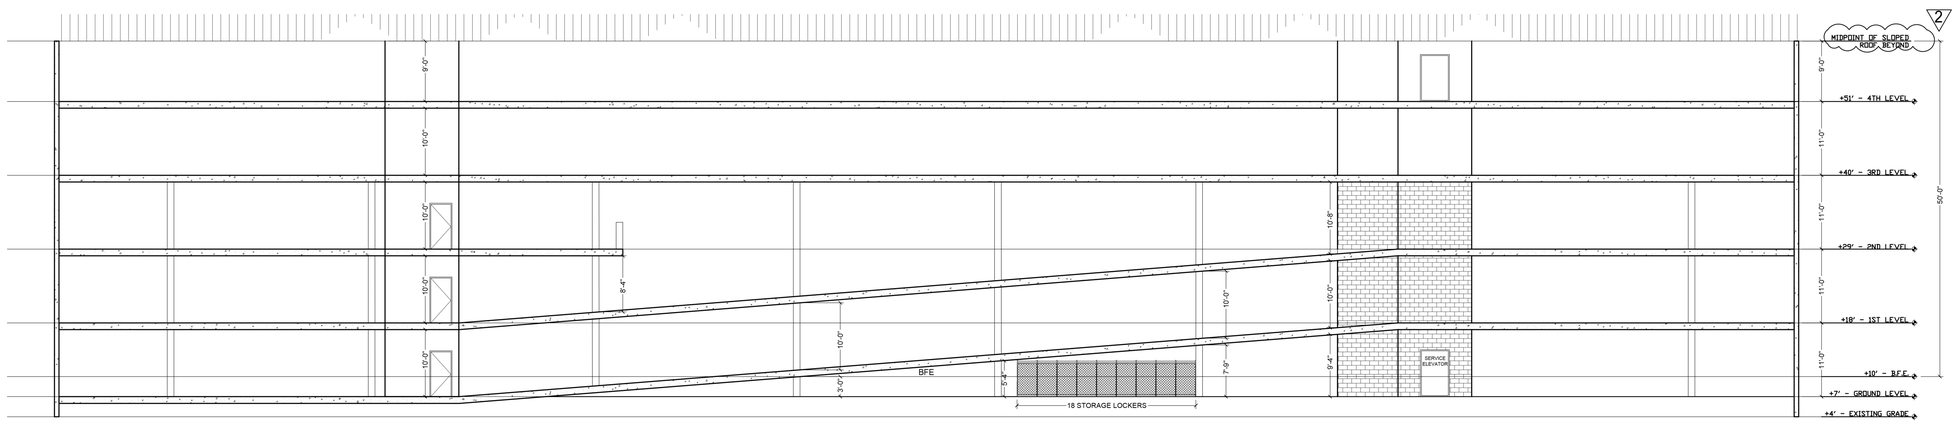

A SECTION A
3/32"=1'-0"

FCP-1 | NICHIHA |
LATURA V-GROOVE | WHITE

FCP-2 | NICHIHA |
ARCHITECTURAL BLOCK | GRAY

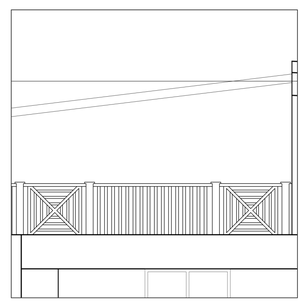

RAILING DETAIL

WINDOW

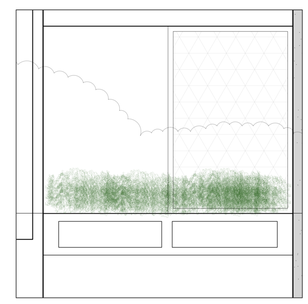

PLANTER BAY DETAIL

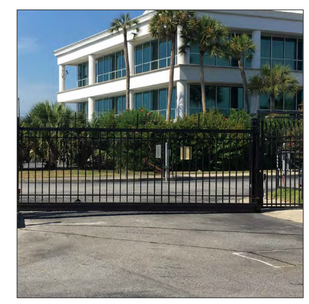

SLIDING SECURITY GATE

1 BASIS OF DESIGN SELECTIONS

BASELINE
Architecture Interior Design Planning

Montclair and North Bergen, New Jersey
www.baselinearch.com

THESE PLANS ARE AN INSTRUMENT OF SERVICE AND ARE THE PROPERTY OF THE ARCHITECT. THE PLANS MAY NOT BE USED FOR ANY OTHER PROJECT, NOR BY ANOTHER ARCHITECT FOR THE CONTINUATION OF THE PROJECT, NOR SOLD WITHOUT THE ARCHITECT'S WRITTEN AUTHORIZATION.

No.	REVISION	Date
2	PLANNING BOARD REVIEW COMMENTS	03/28/2023

ARCHITECT OF RECORD

ALAN J. HORWITZ, AIA, LEED AP BD C
FL LICENSE AR101841
6701 JF KENNEDY BLVD
NORTH BERGEN, NJ 07047
908-331-1948

STATE OF FLORIDA — ALAN J HORWITZ — AR101841 — REGISTERED ARCHITECT

Printed copies of this document are not considered signed and sealed, and the signature must be verified on any electronic copies.

Digitally signed by Alan Horwitz
Date: 2023.03.29 15:57:25 -04'00'

No.	Issue	Date
1	PLANNING BOARD REVIEW	9/13/22
2	PLANNING BOARD SUBMISSION - UPDATED	12/9/22

PROJECT
E -Residences Marco Island
717 South Collier Blvd.
Marco Island, FL

DRAWING TITLE
SOUTH & NORTH ELEVATION
SECTION

PROJECT NO. 22003

SHEET NO. A-201